



Engineering Support Services

Continuous Improvement through Positive Action

Bluebeam Training


Commenting in a Studio Session




Bluebeam
Revu 2018


Open Bluebeam from
your desktop.



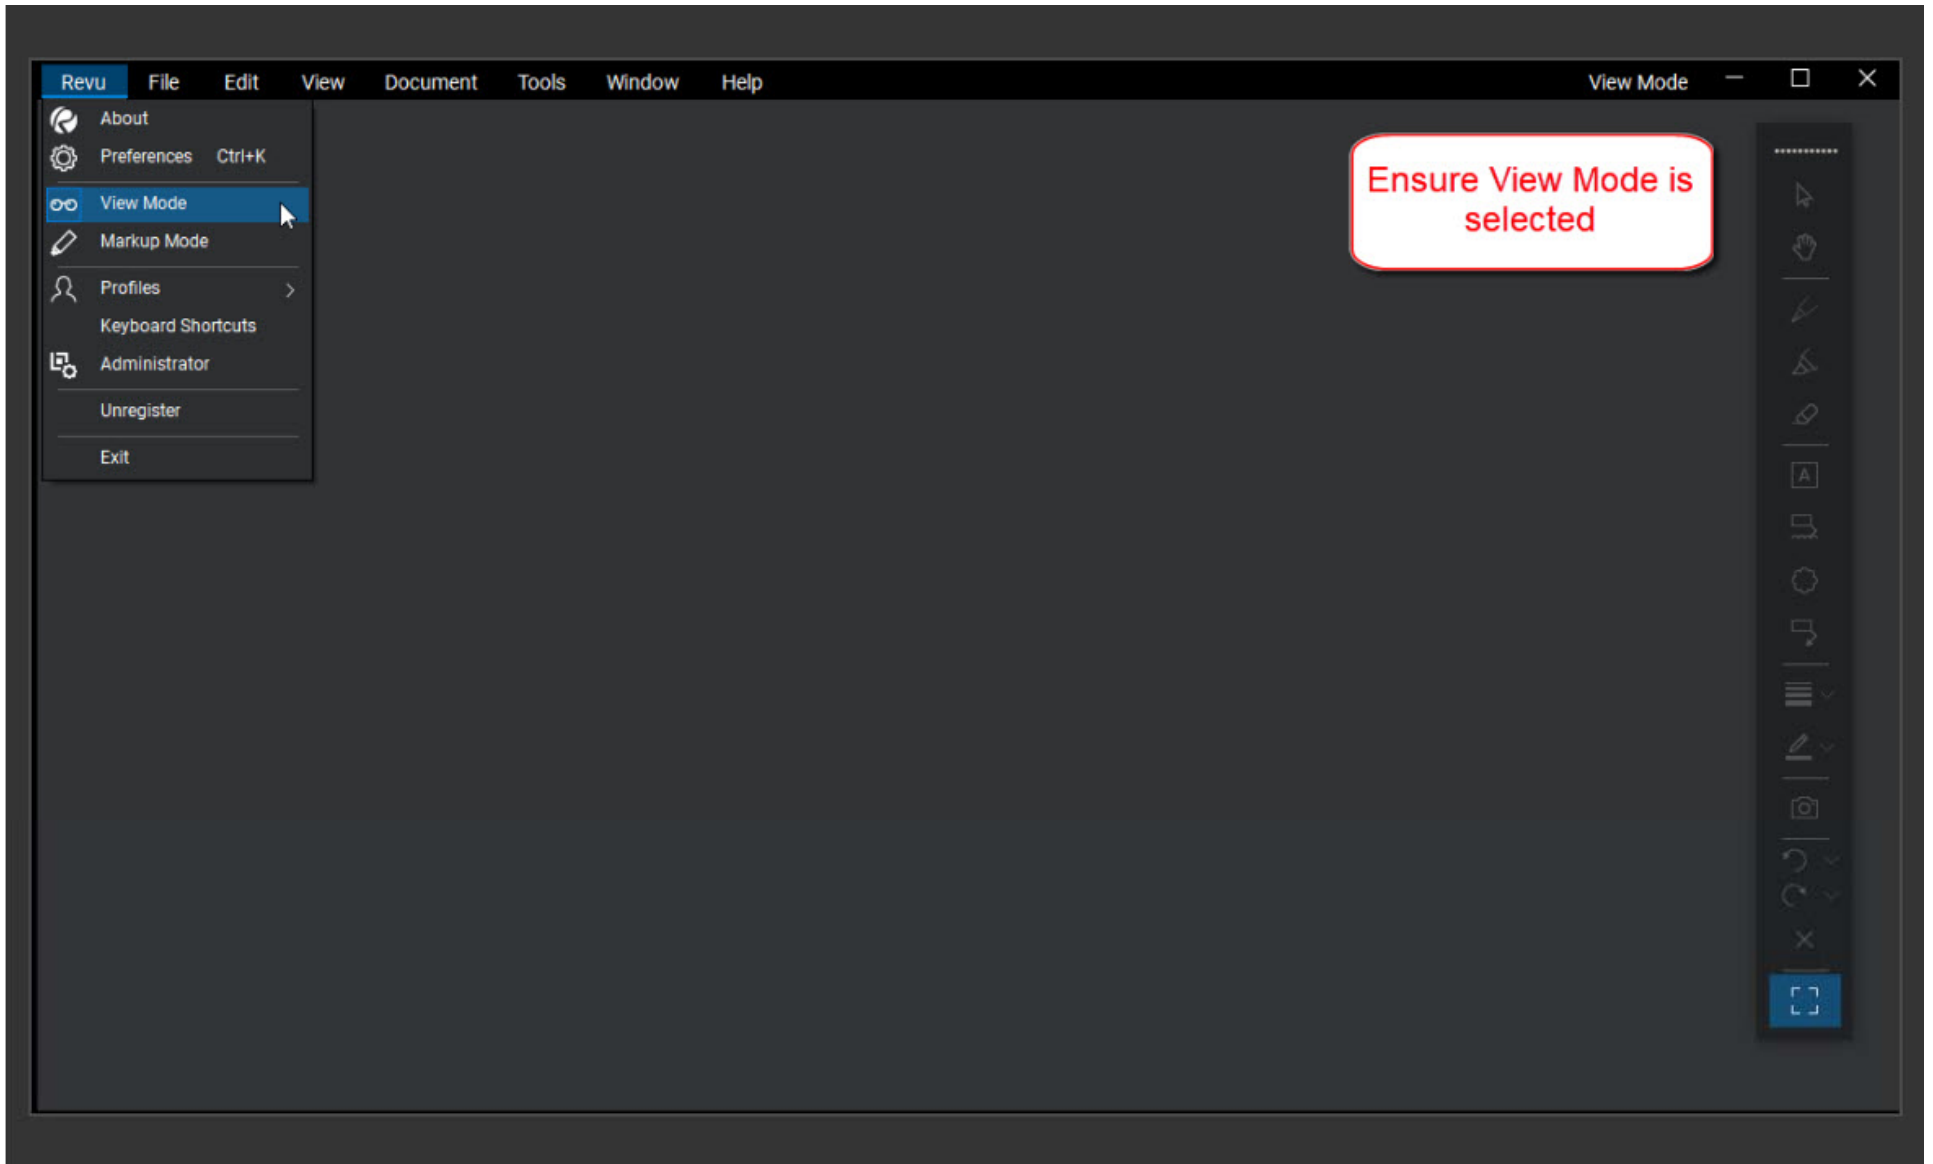




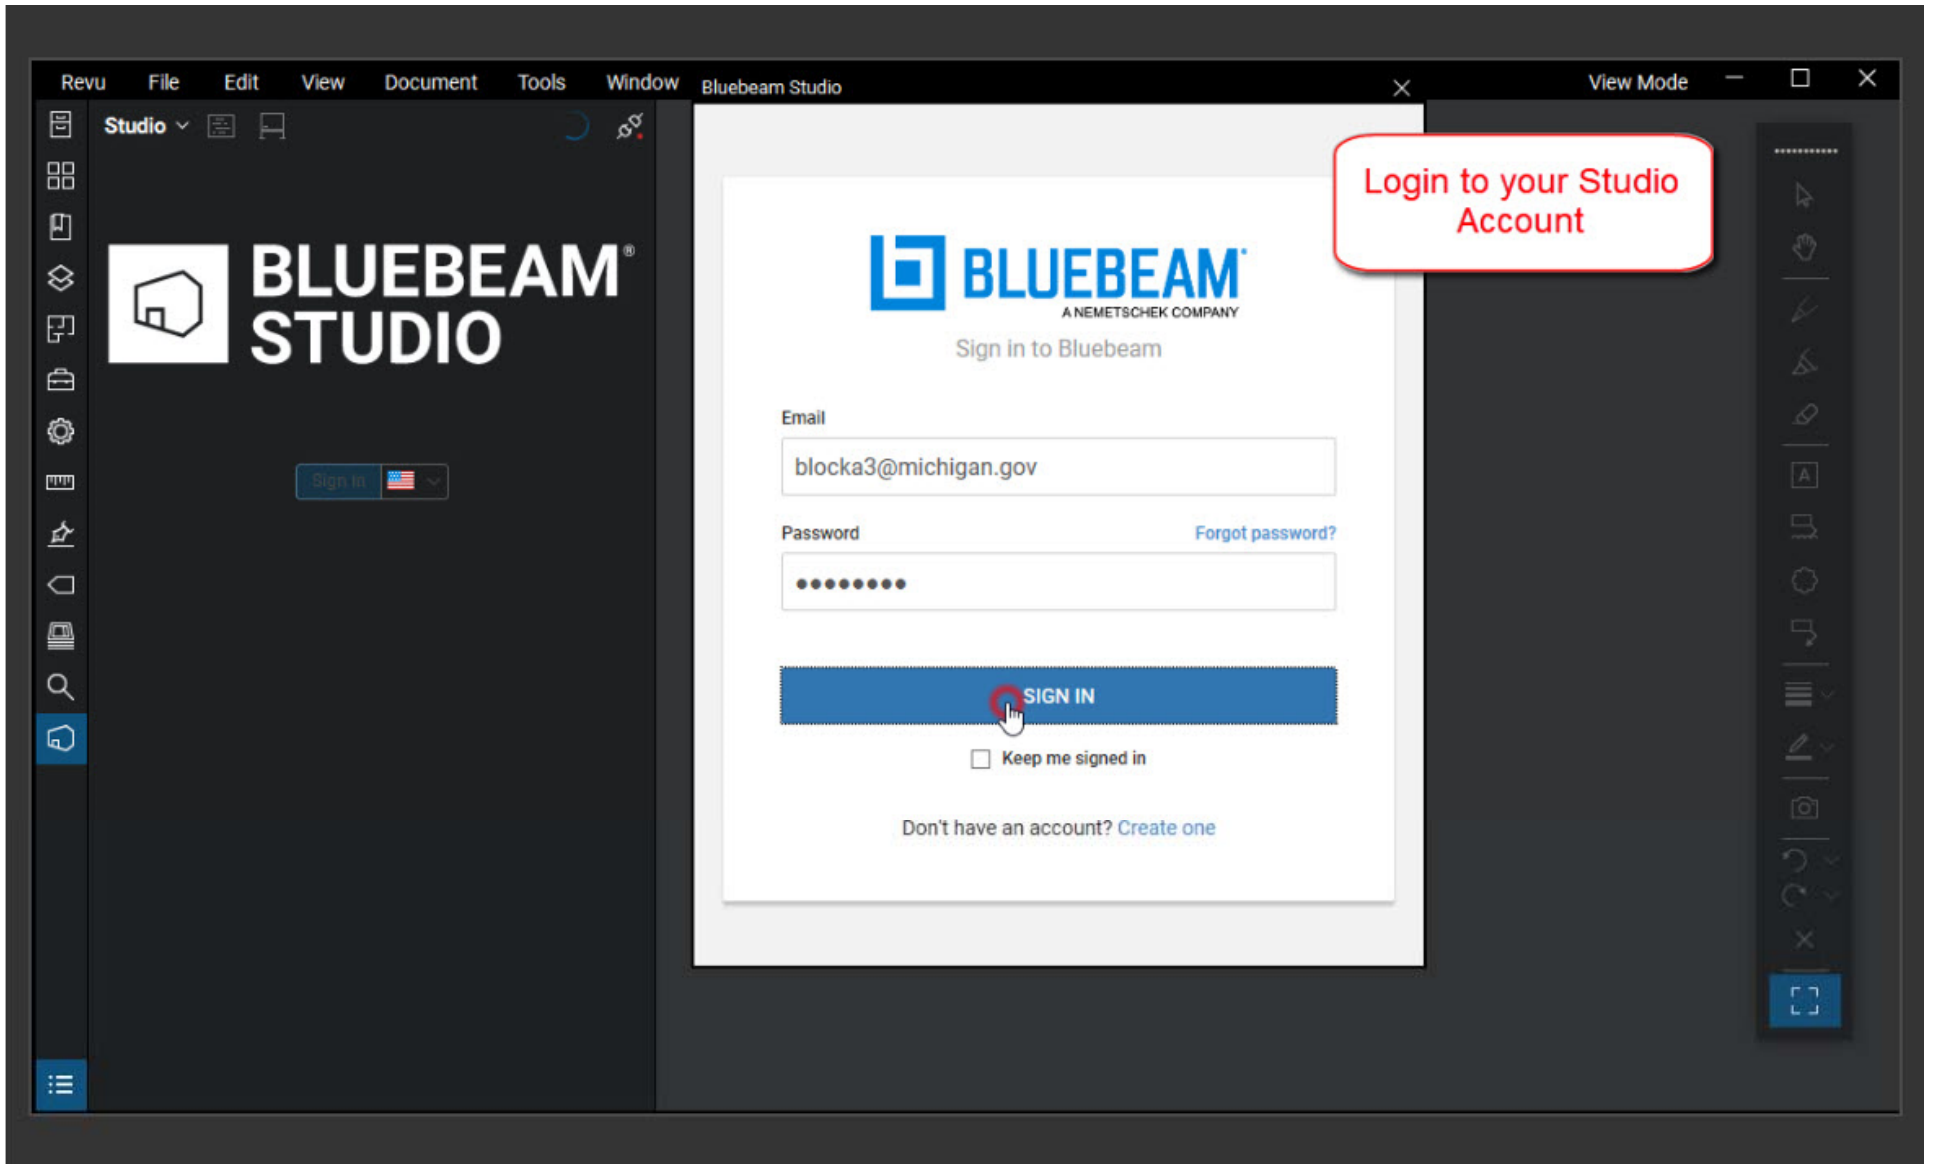

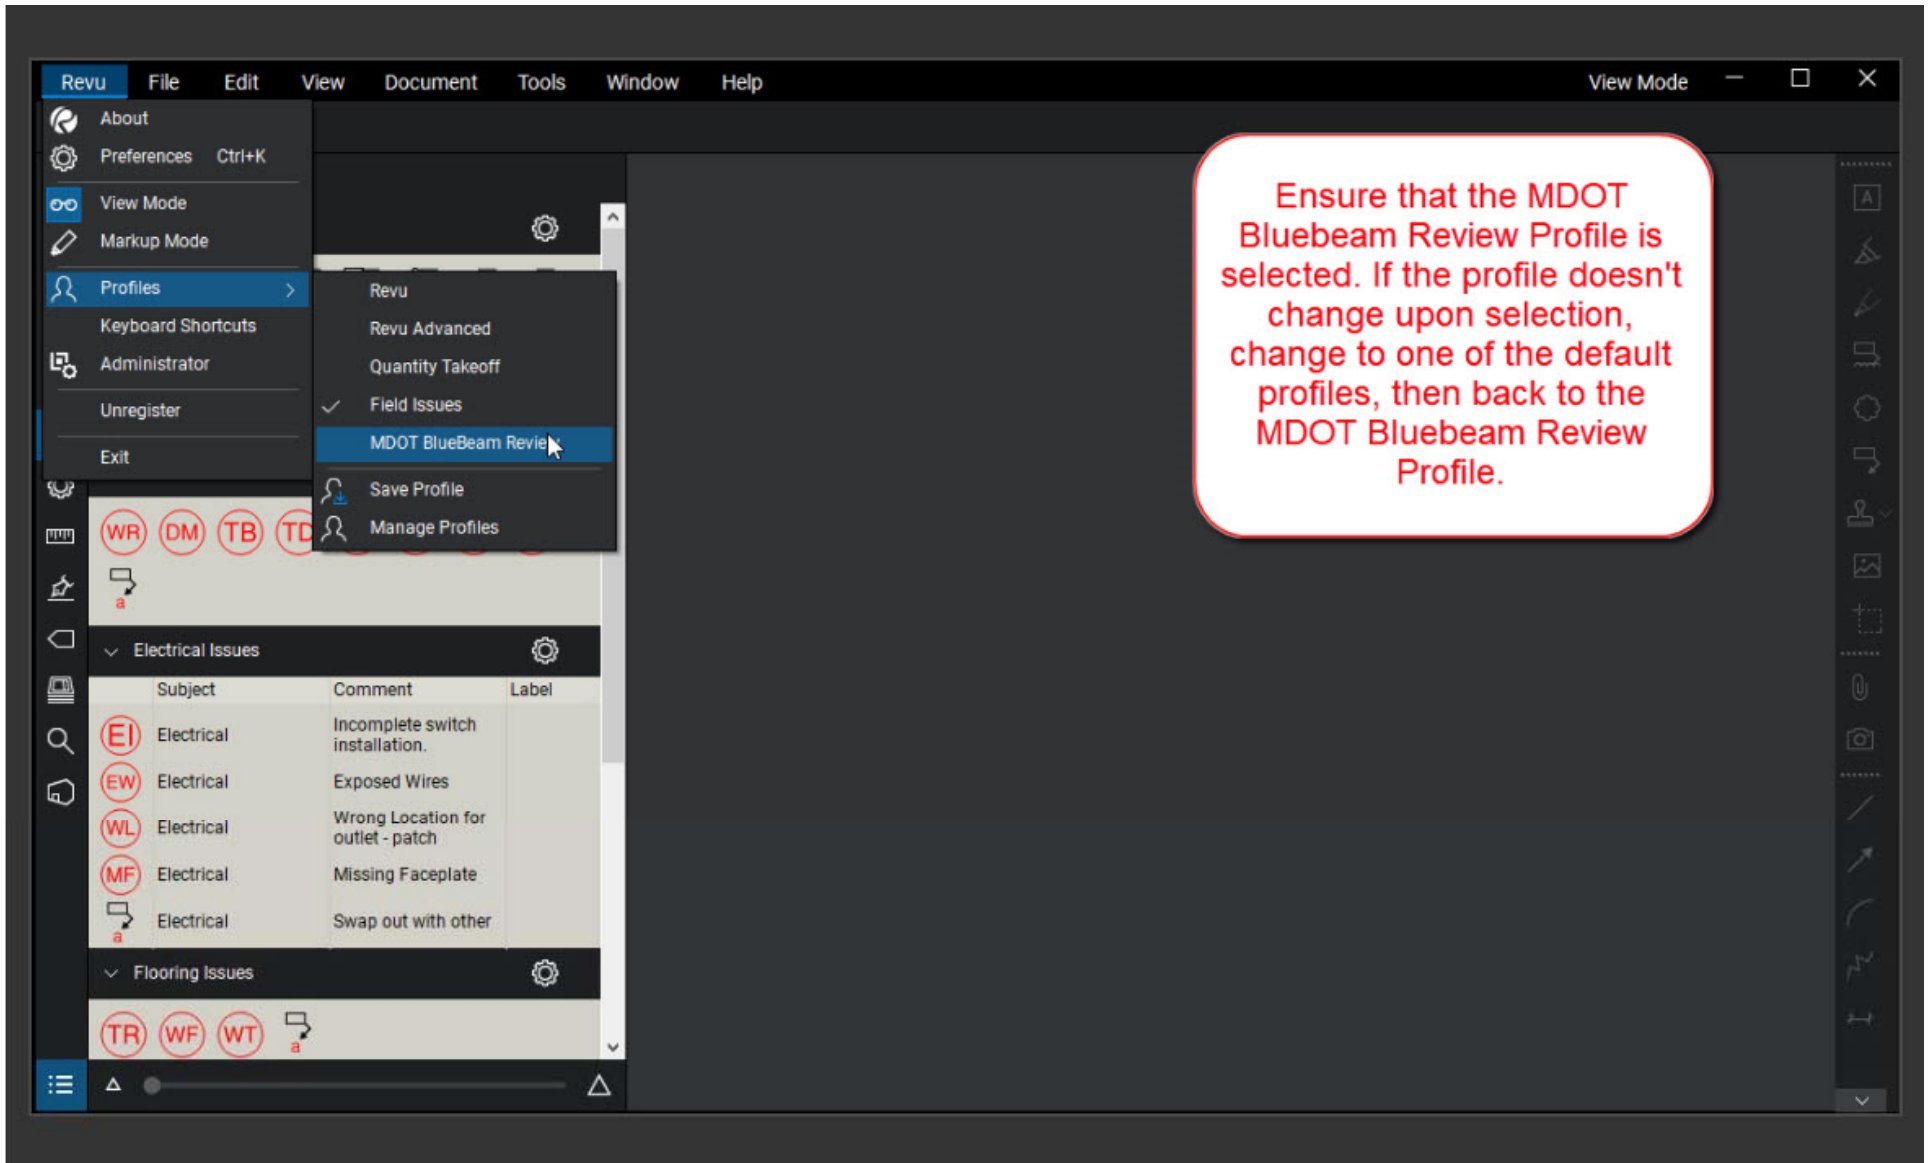



Ensure that the MDOT Bluebeam Review Profile is selected. If the profile doesn't change upon selection, change to one of the default profiles, then back to the MDOT Bluebeam Review Profile.

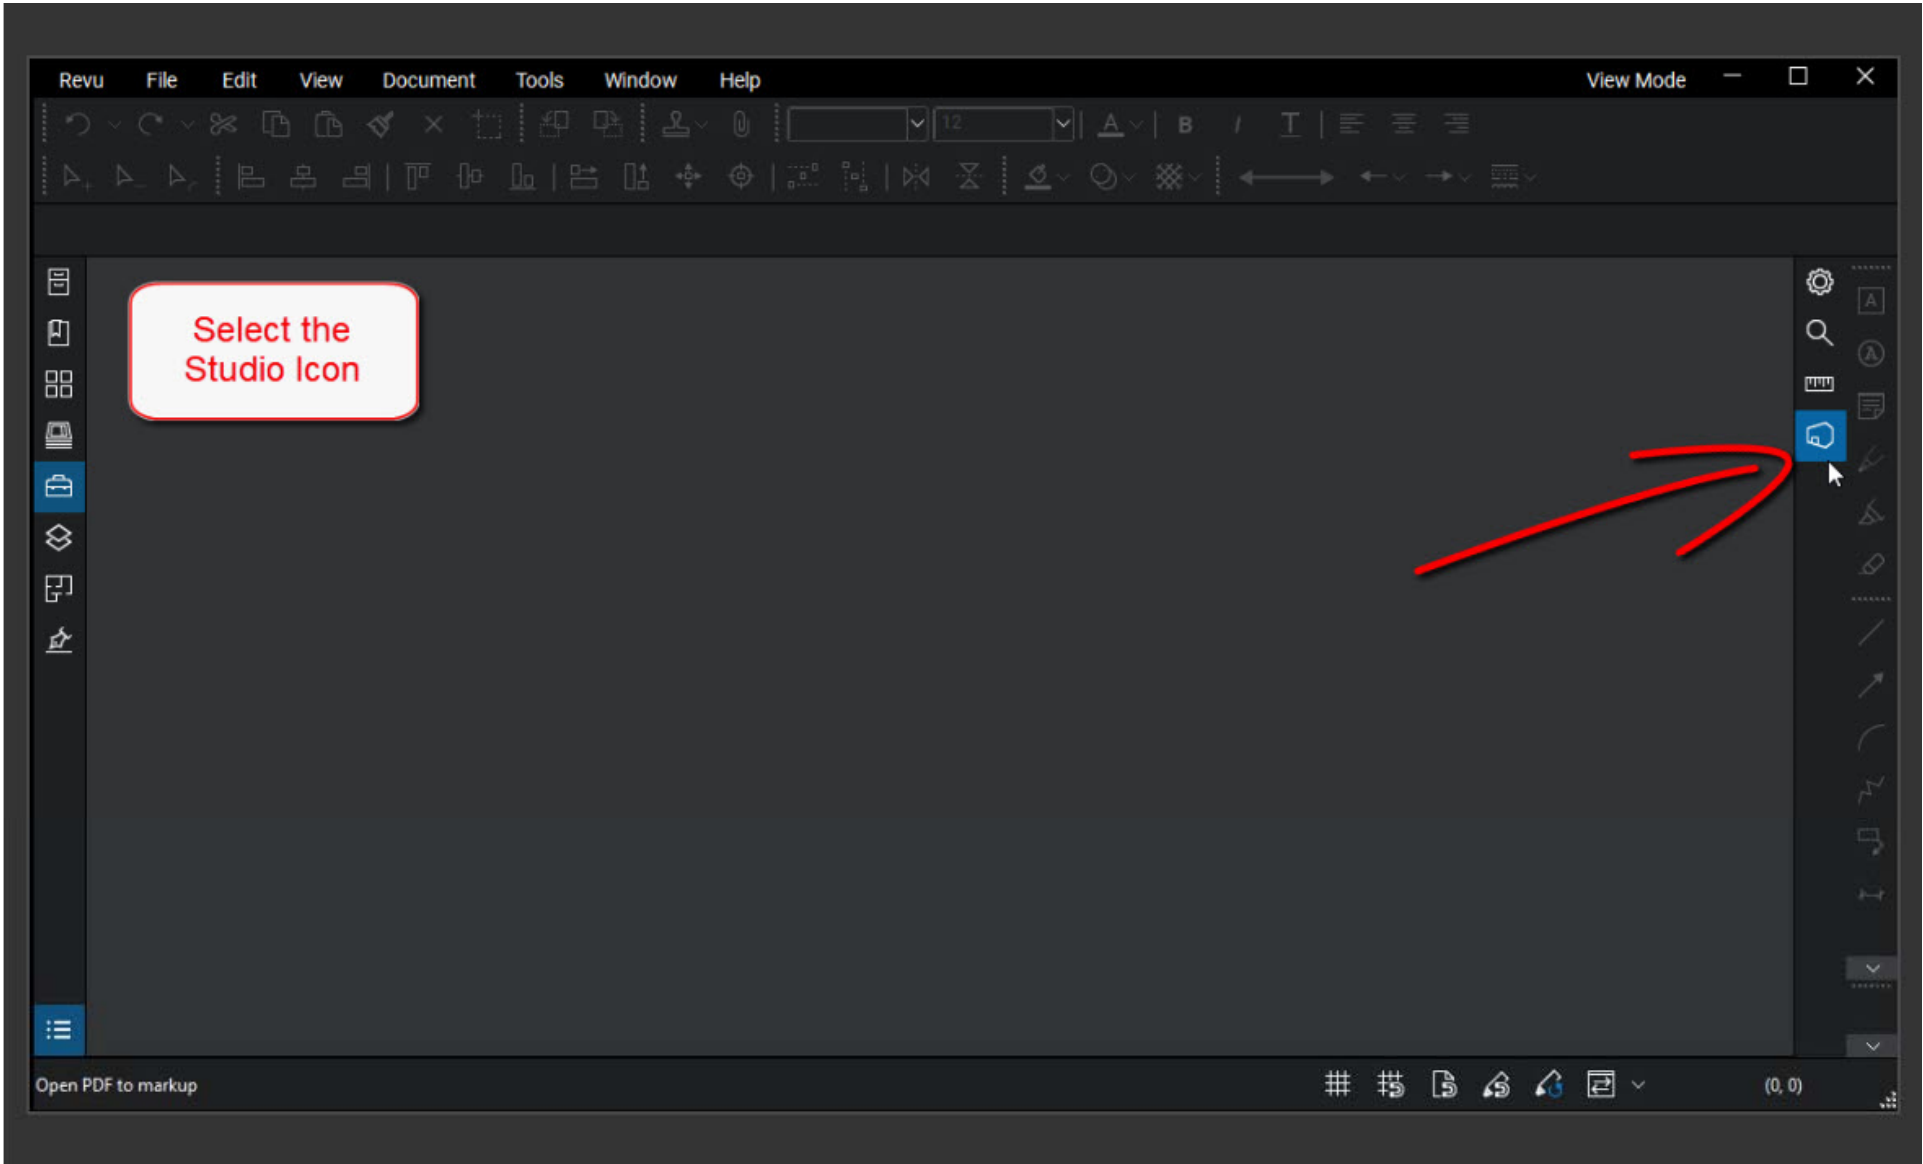


Select the Studio Icon



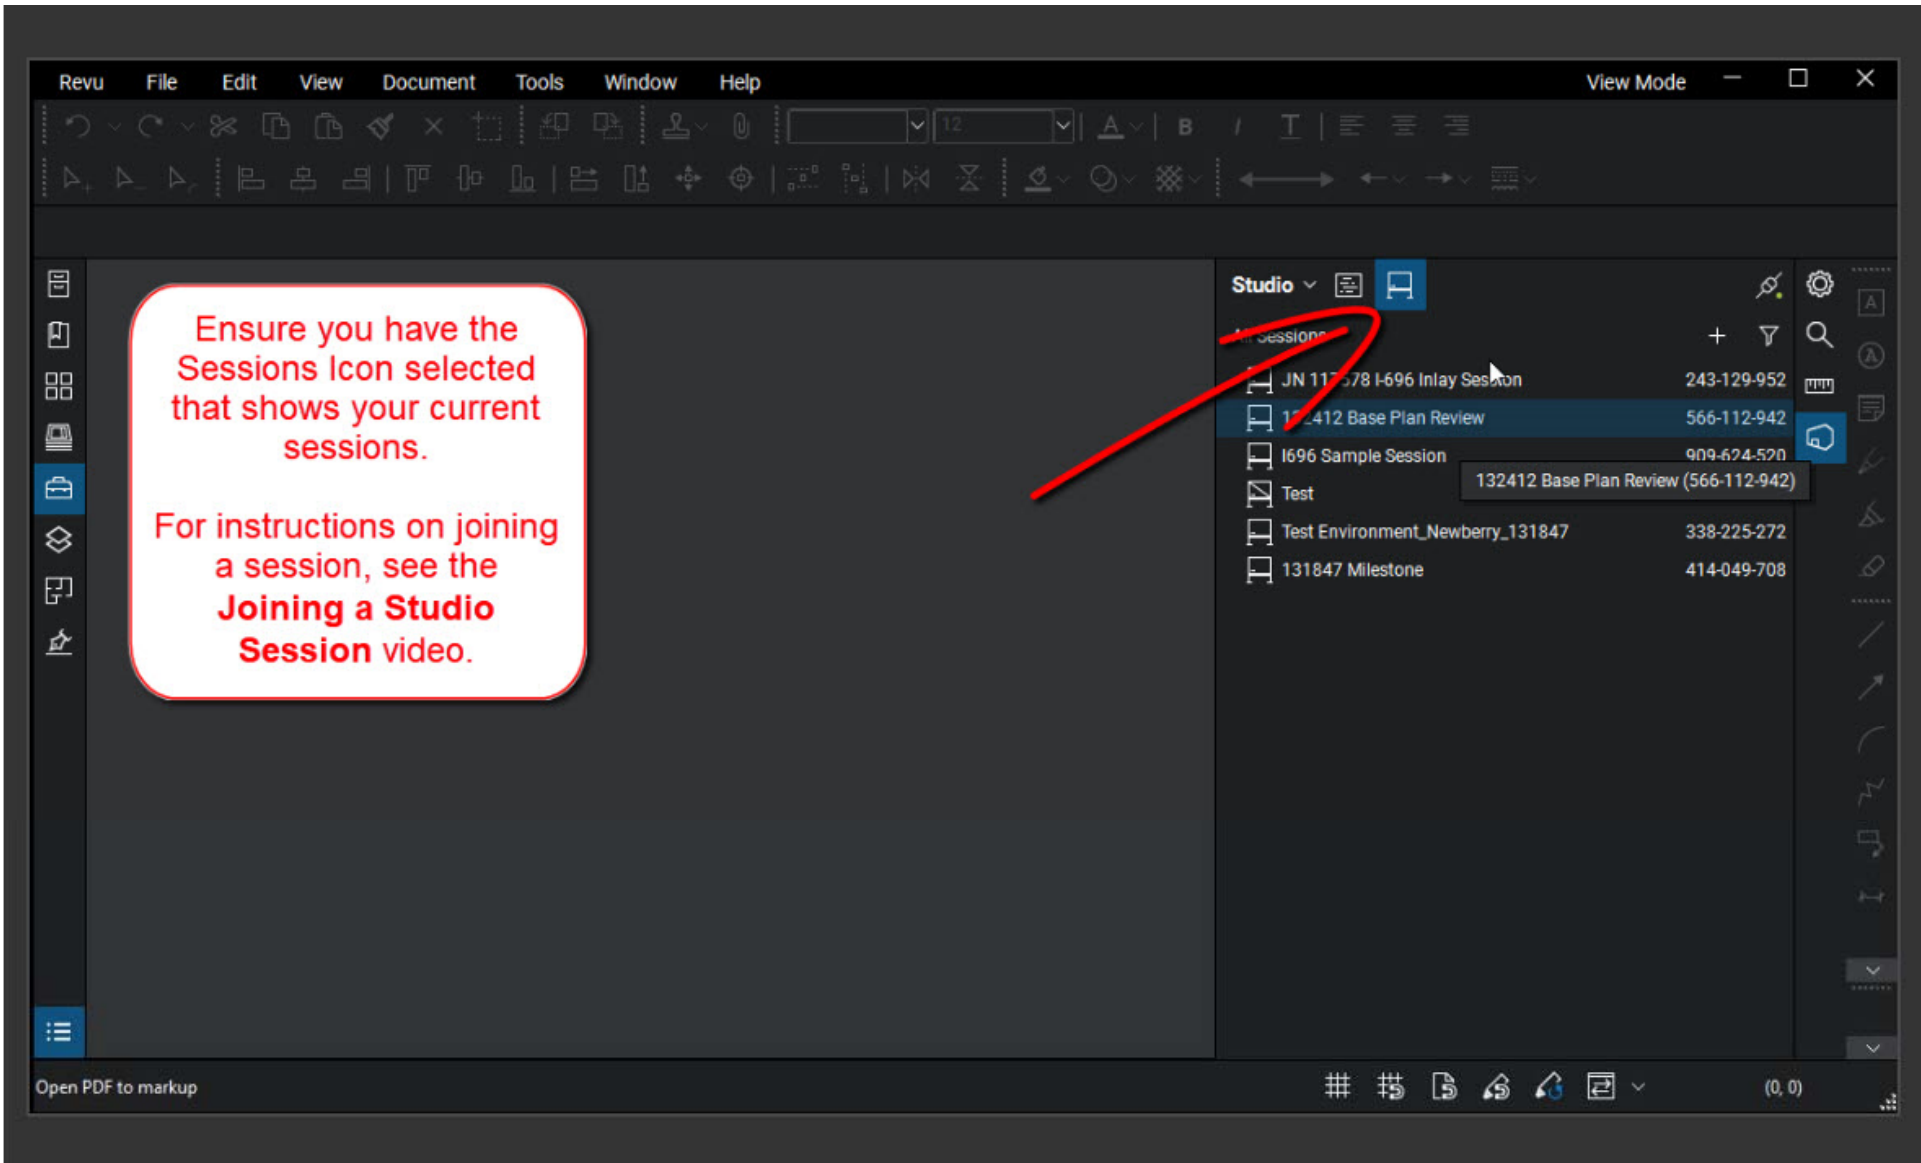

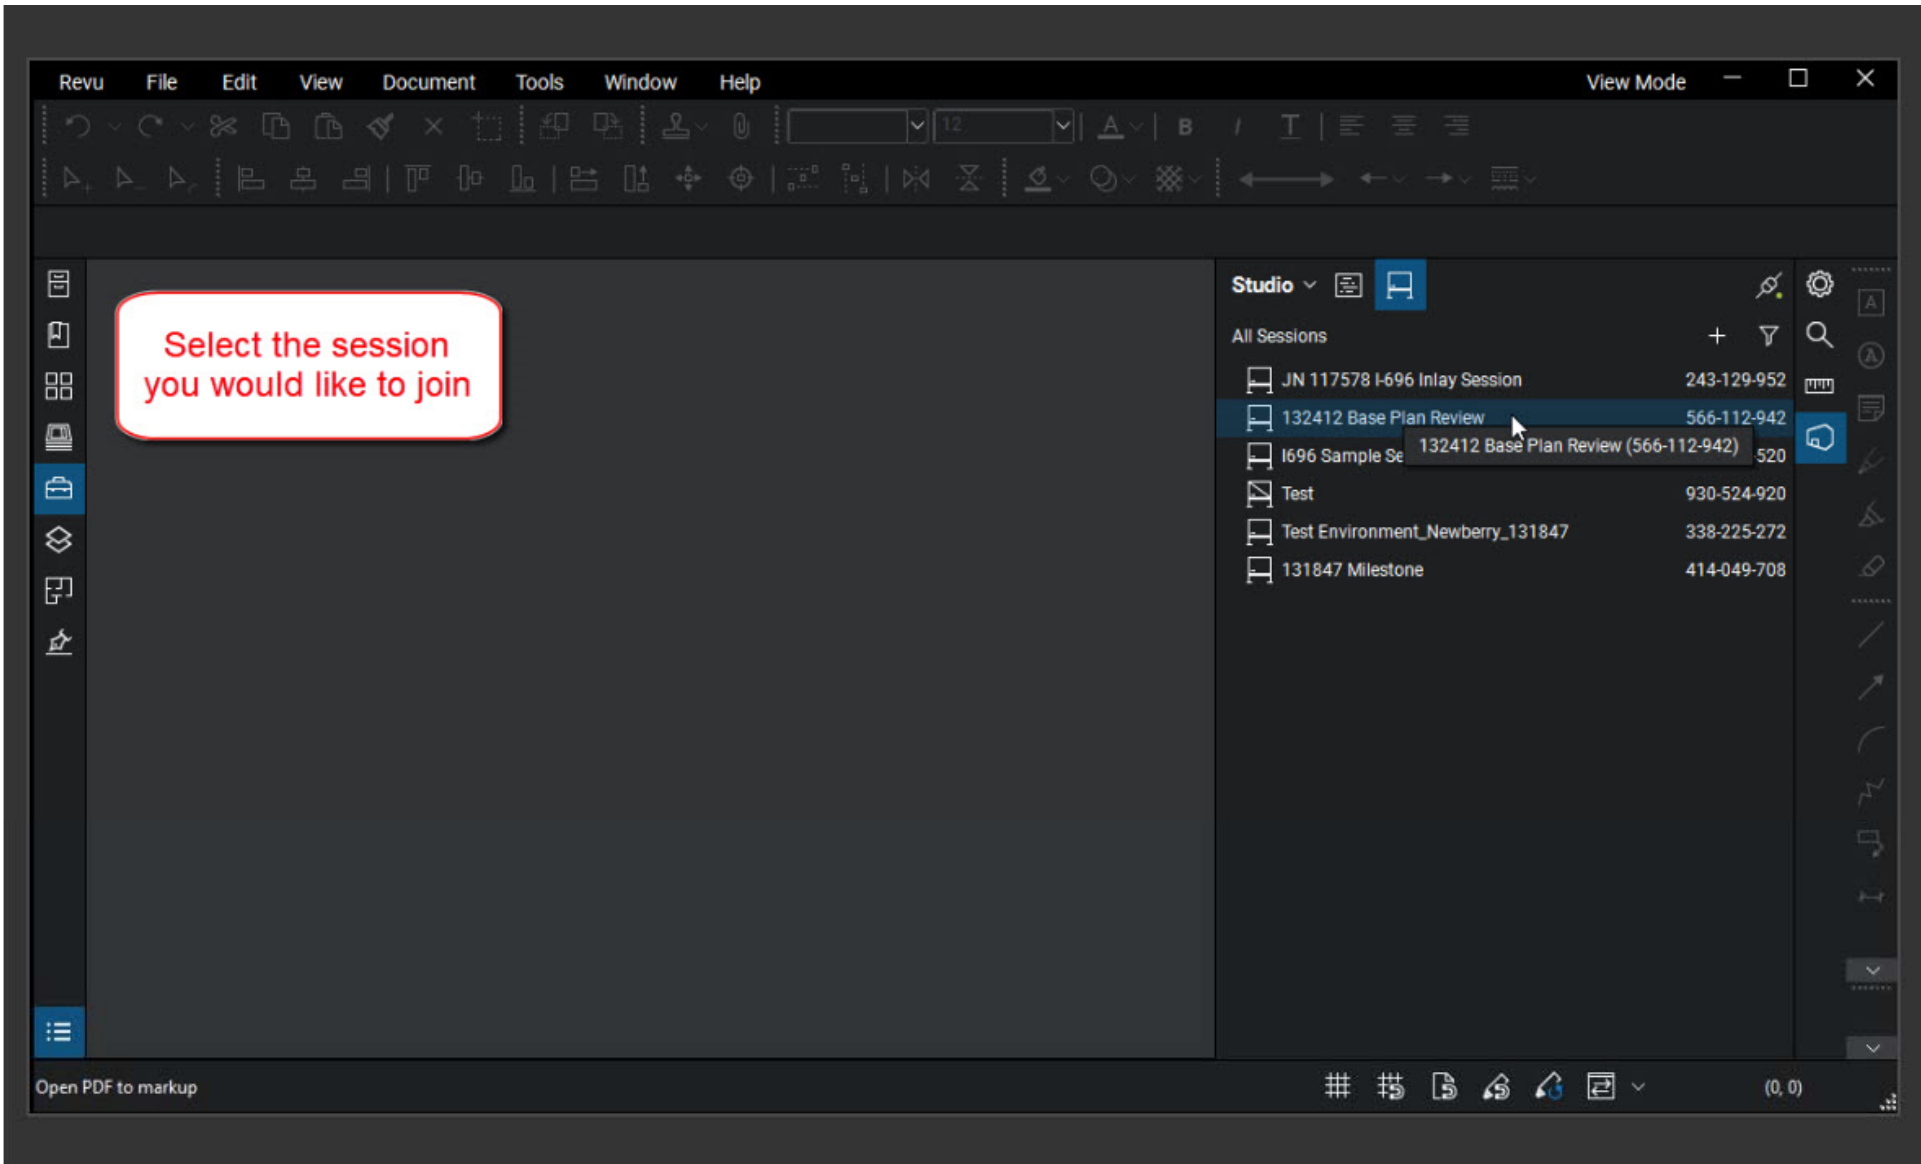

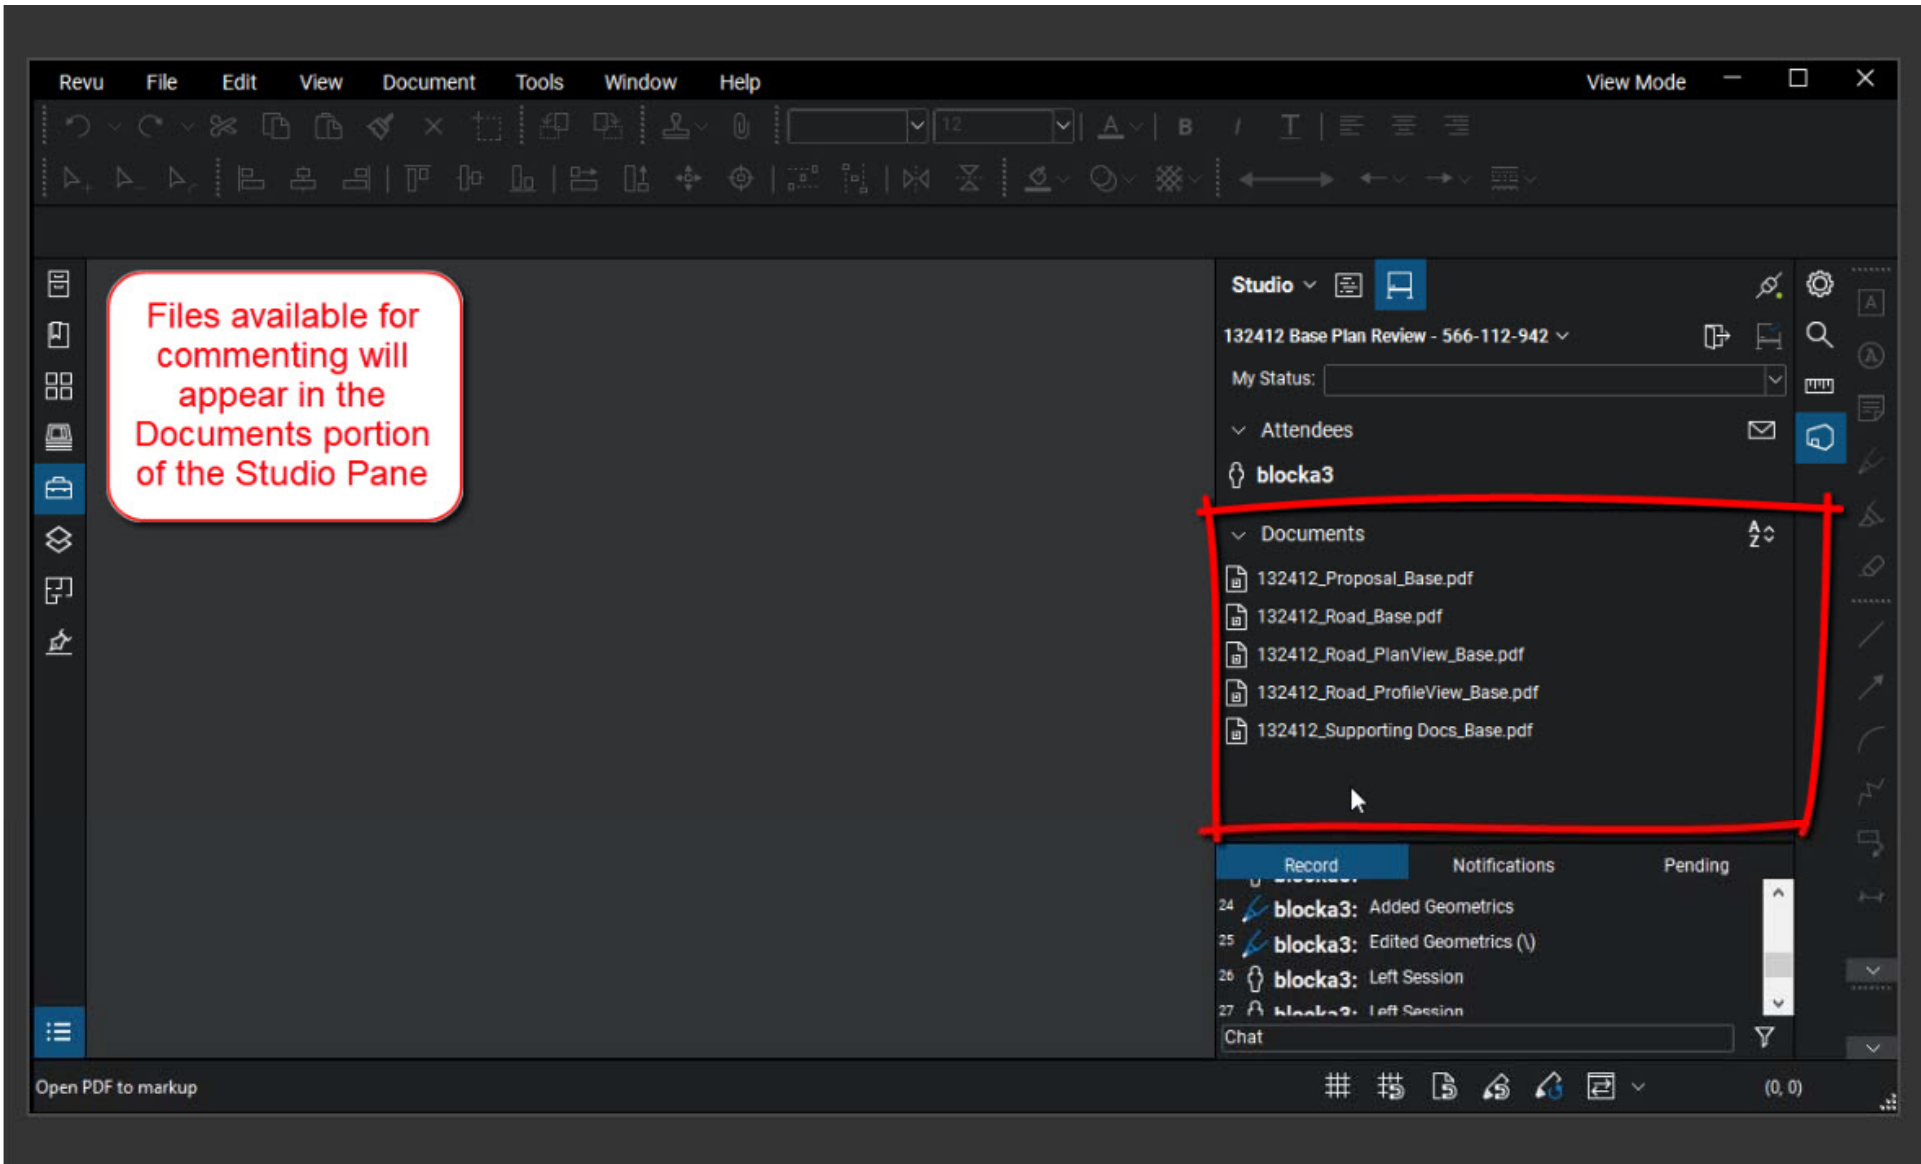



Session: 132412 Base Plan Review ID: 566-112-942 Name: 8392581 Pages: 16

Select the documents you wish to view and comment on

MICHIGAN DEPARTMENT OF TRANSPORTATION

ROUTE: US-131
VILLAGE OF FIVE LAKE
FIVE LAKE TOWNSHIP
GRAND TRAVERSE COUNTY

SECTION	CONTROL SEC	JOB NO.	PROJECT	JTM	FEDERAL
1	2891	132412A			

BASE PLANS
18/04/17
PLAN SUBJECT TO CHANGE

APPROVALS

MICHIGAN DEPARTMENT OF TRANSPORTATION
SUN I. STANG, PE - ENGINEER

1 of 16

Studio

132412 Base Plan Review - 566-112-942

My Status: [dropdown]

Attendees

blocka3 132412_Road_Base.pdf, 1


Documents

- 132412_Proposal_Base.pdf
- 132412_Road_Base.pdf
- 132412_Road_PlanView_Base.pdf
- 132412_Road_ProfileView_Base.pdf
- 132412_Supporting Docs_Base.pdf

Record Notifications Pending

- 24 blocka3: Added Geometrics
- 25 blocka3: Edited Geometrics (1)
- 26 blocka3: Left Session
- 27 blocka3: Left Session

Chat

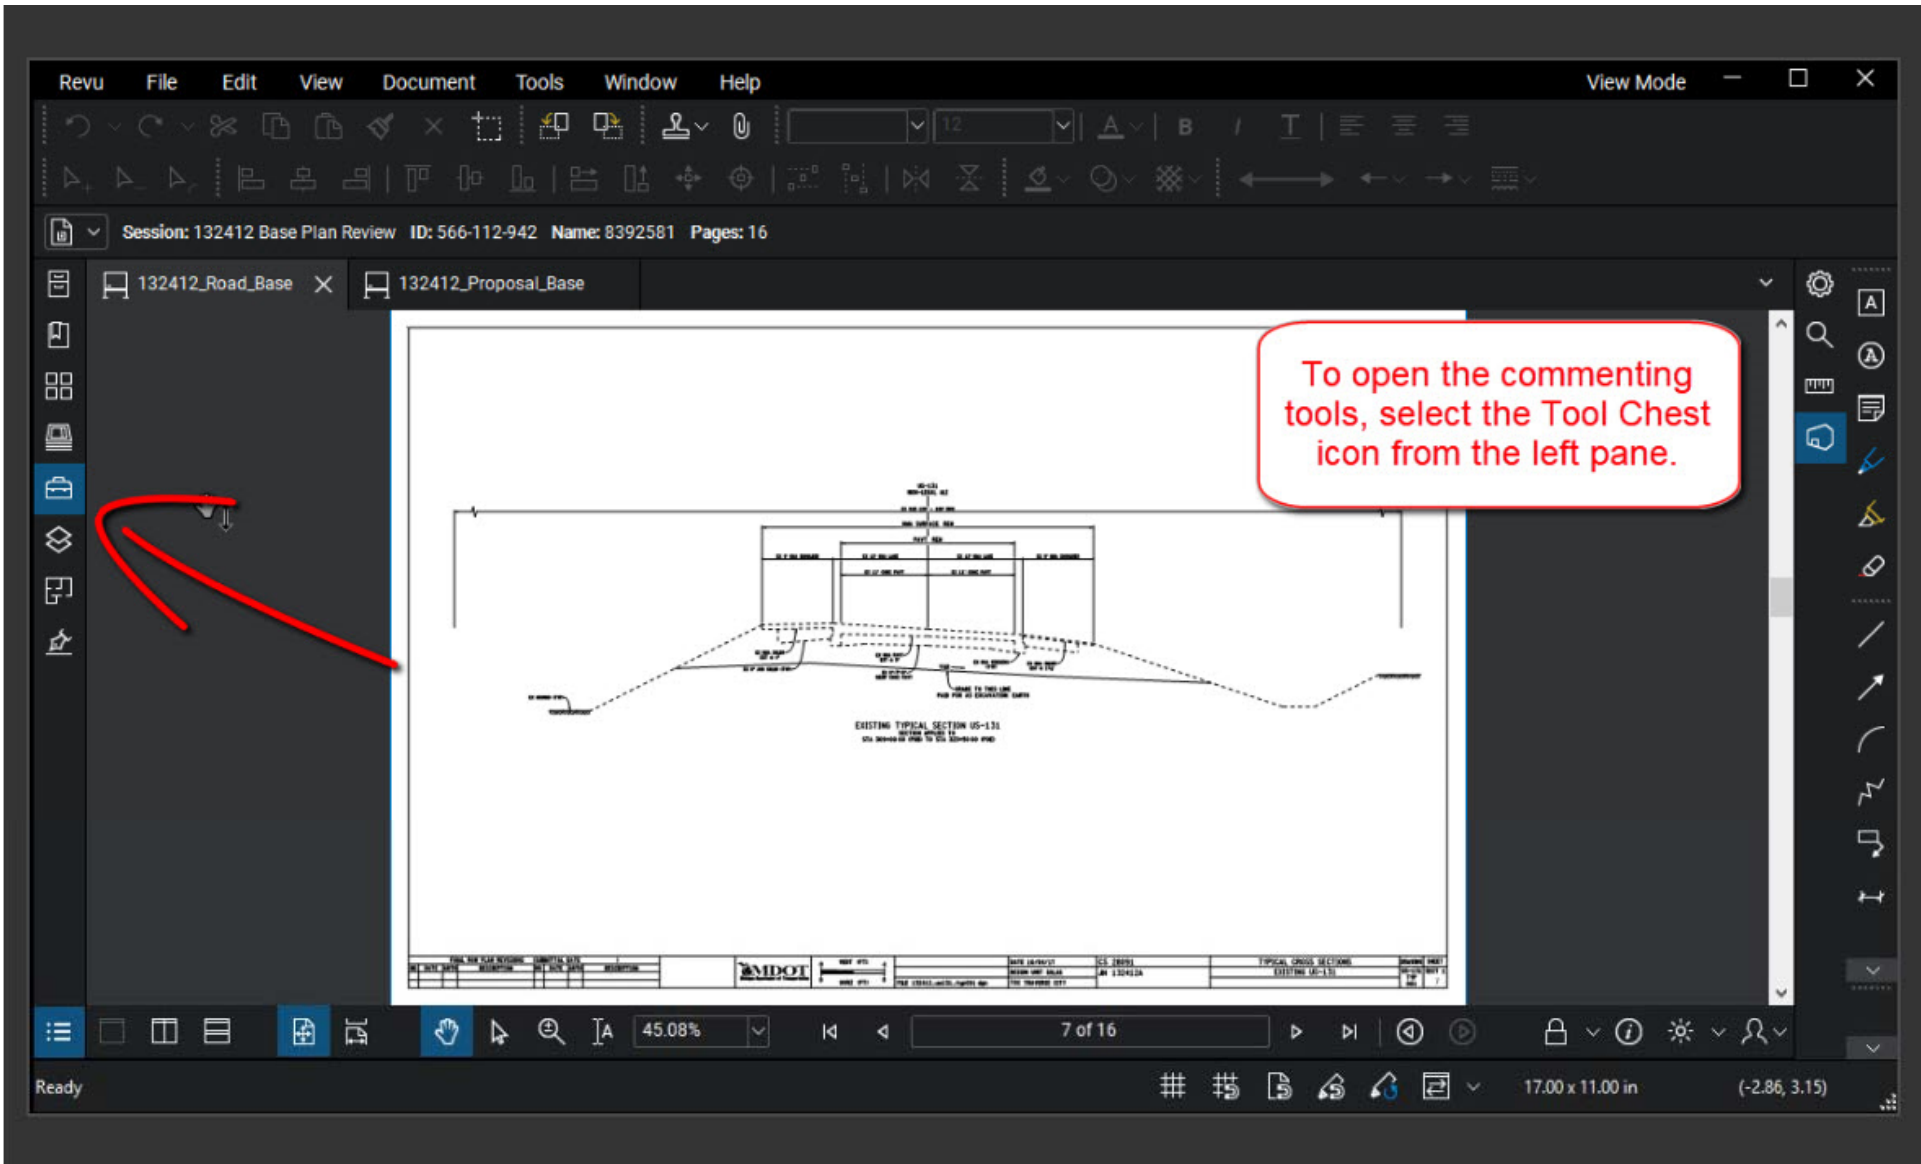

Revu File Edit View Document Tools Window Help View Mode

Session: 132412 Base Plan Review ID: 566-112-942 Name: 8392581 Pages: 16

132412_Road_Base 132412_Proposal_Base

Tool Chest

- My Tools
- Region & TSCs
- Geotech & CFS
- Environmental & SESC
- Geometrics**
- Hydraulics
- Quality Assurance
- Real Estate
- Signals & Signing
- Railroad

EXISTING TYPICAL SECTION US-131
EXISTING TYPICAL SECTION US-131
EXISTING TYPICAL SECTION US-131

45.08%

17.00 x 11.00 in (-4.71, 1.44)

Ready

For comment tracking purposes ensure you are utilizing the most applicable tool set for your position and section.

Revu File Edit View Document Tools Window Help View Mode

Session: 132412 Base Plan Review ID: 566-112-942 Name: 8392581 Pages: 16

132412_Road_Base 132412_Proposal_Base

Verify

Select a tool from the pane to comment on the files.

US-131
NON-LEGAL ALI
EX VAR 120' - 180' ROW
HMA SURFACE, REM
PAVT, REM
HOULDER EX 12' HMA LANE EX 12' HMA LANE EX
EX 11' CONC PAVT EX 11' CONC PAVT

Ready # 17.00 x 11.00 in (6.64, 3.38)

Revu File Edit View Document Tools Window Help View Mode

Session: 132412 Base Plan Review ID: 566-112-942 Name: 8392581 Pages: 16

132412_Road_Base 132412_Proposal_Base

Tool Chest

- My Tools
- Region & TSCs
- Geotech & CFS
- Environmental & SESC
- Geometrics
- Hydraulics
- Quality Assurance
- Real Estate
- Signals & Signing
- Railroad

text

Verify

US-134
NON-LEGAL ALI

EX VAR 120' - 180' ROW

HMA SURFACE, REM

PAVT, REM

EX 9' HMA SHOULDER

EX 12' HMA LANE


EX 11' CONC PAVT

EX 12' HMA LANE

EX 9' HMA SHOULDER

Comments will be grouped by which toolset is utilized. For your review, use only the toolset applicable to your section, don't change tool sets for different types of comments.

Ready 134.60% 17.00 x 11.00 in (5.29, 3.18)

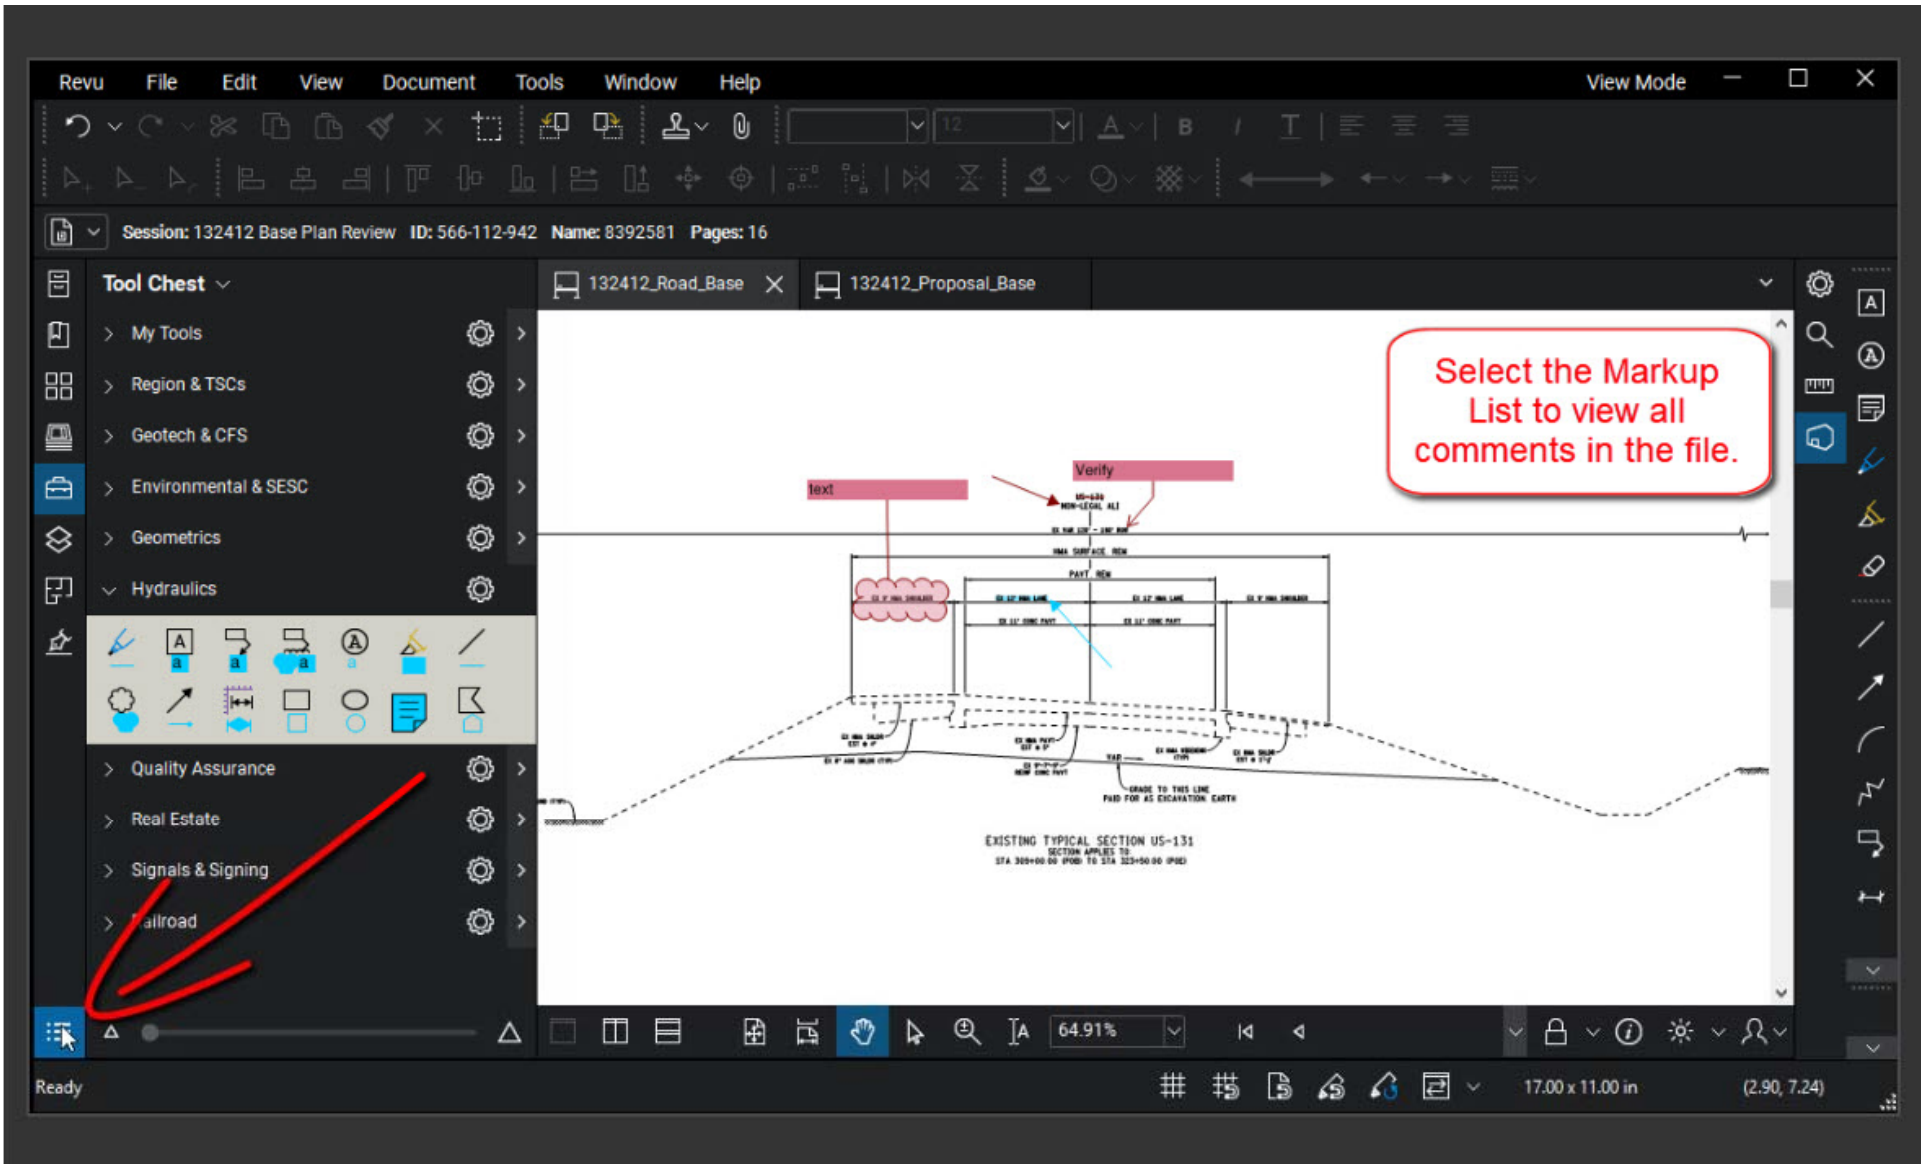

Revu File Edit View Document Tools Window Help View Mode

Line: 100% 1.00 pt Start: End: Auto

132412_Road_Base 132412_Proposal_Base

text Verify

Selecting a comment from the list will move the document to that comment.

Markups List

Subject	Page Label	Lock	Status	Checkmark	Author	Date	Color	Comments
Hydraulics (2)								
[A] Hydraulics	7	<input type="checkbox"/>		<input type="checkbox"/>	blocka3	8/9/20...	■	EX 12' HMA LANE
Hydraulics	7	<input checked="" type="checkbox"/>		<input checked="" type="checkbox"/>	blocka3	8/9/20...	■	
MOT (2)								
[A] MOT	1	<input type="checkbox"/>		<input type="checkbox"/>	armourj1...	5/1/20...	■	
MOT	1	<input type="checkbox"/>		<input type="checkbox"/>	armourj1...	5/1/20...	■	

Drag control points to resize, or drag line to move 17.00 x 11.00 in (2.90, 7.24)

Revu File Edit View Document Tools Window Help View Mode

Session: 132412 Base Plan Review ID: 566-112-942 Name: 8392581 Pages: 16

132412_Road_Base 132412_Proposal_Base

Tool Chest

- My Tools
- Region & TSCs
- Geotech & CFS
- Environmental & SESC
- Geometrics
- Hydraulics
- Quality Assurance
- Real Estate
- Signals & Signing
- Railroad

EXISTING TYPICAL SECTION 10-131
REPAIR BRIDGE TO
EX. BRIDGE ON P&E TO THE 2000' 00' 00"

All comments are automatically saved when placed in a Studio Session


AMDOT


DATE: 10/14/11	DATE: 10/14/11	DATE: 10/14/11	DATE: 10/14/11
BY: [Name]	BY: [Name]	BY: [Name]	BY: [Name]
CHECKED: [Name]	CHECKED: [Name]	CHECKED: [Name]	CHECKED: [Name]
APPROVED: [Name]	APPROVED: [Name]	APPROVED: [Name]	APPROVED: [Name]

TYPICAL CROSS SECTION
EXISTING 10-131

45.08%

17.00 x 11.00 in (10.72, 6.50)

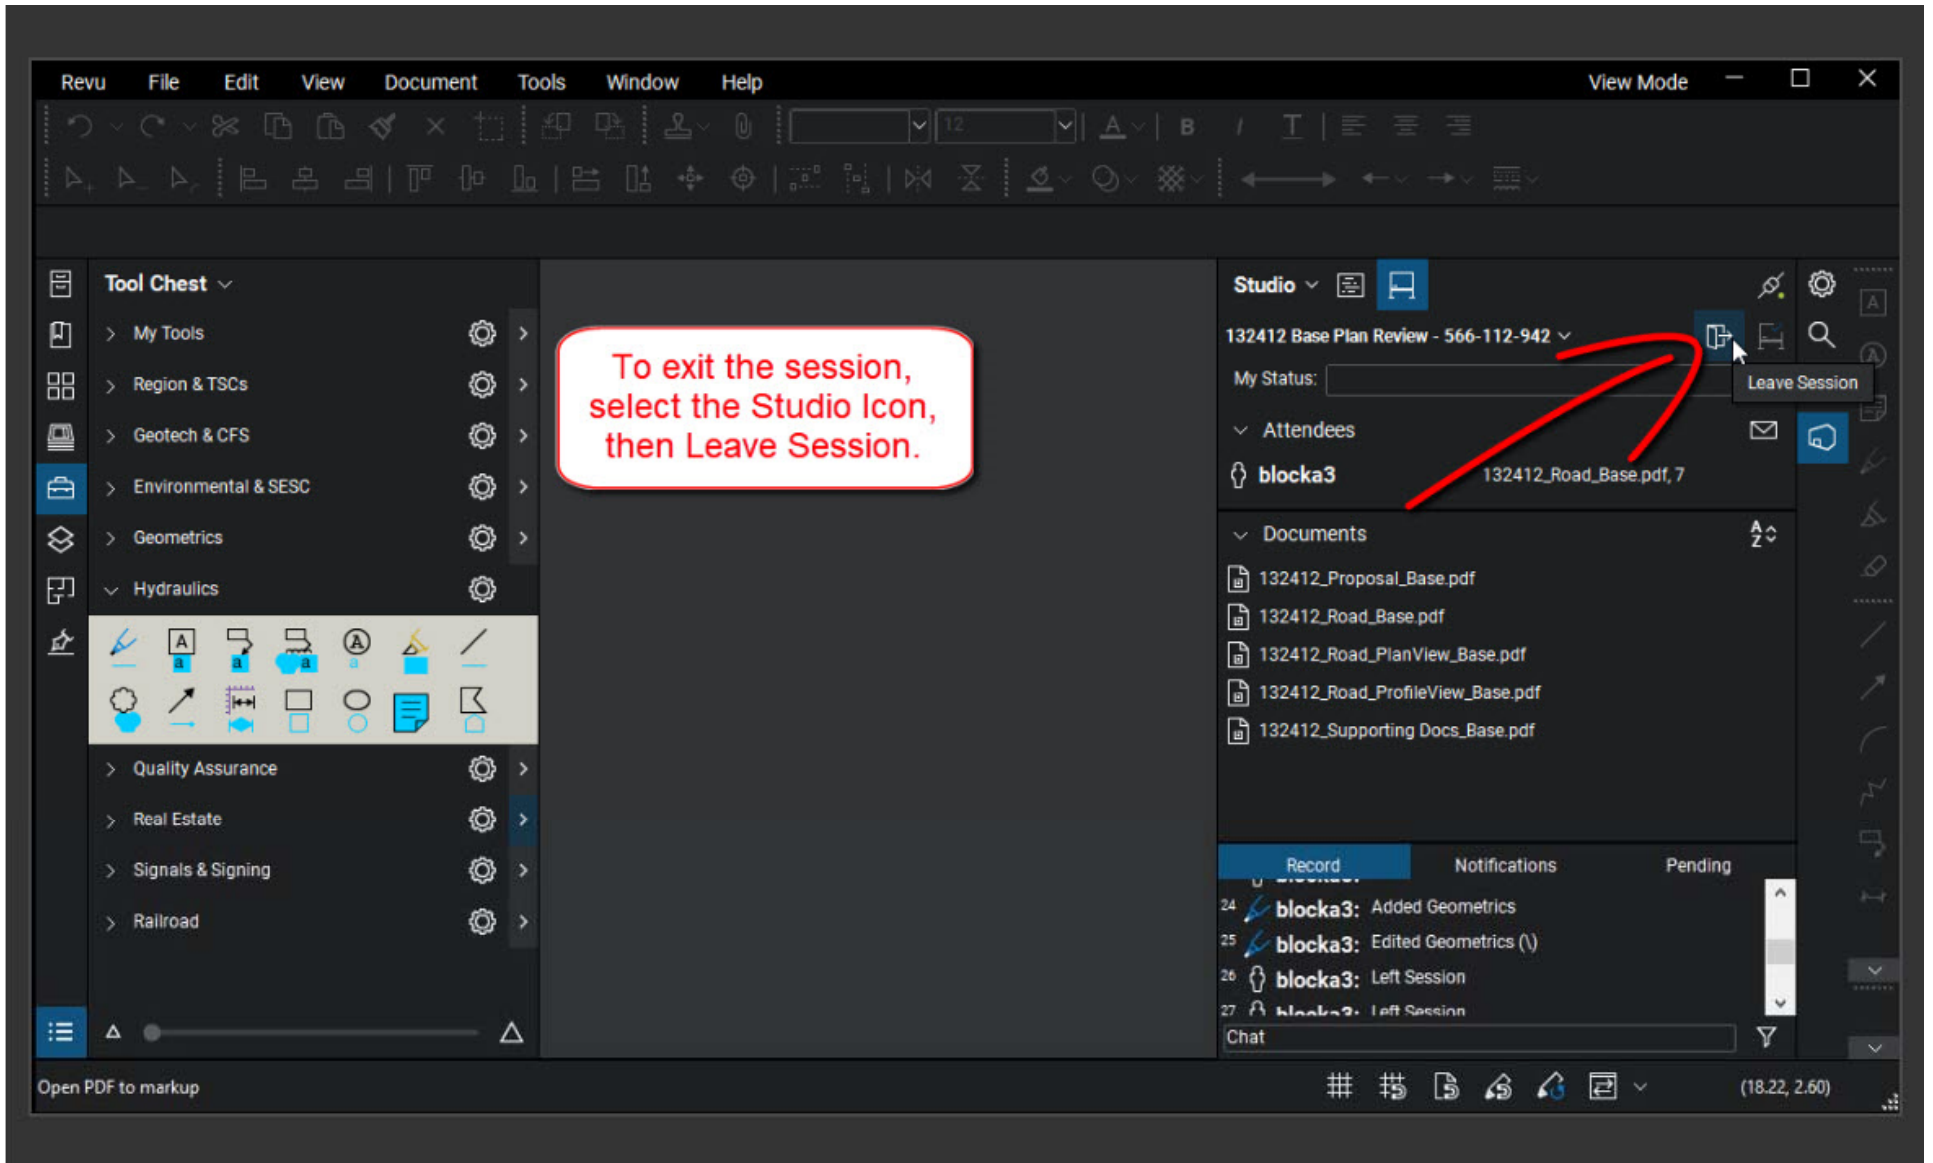

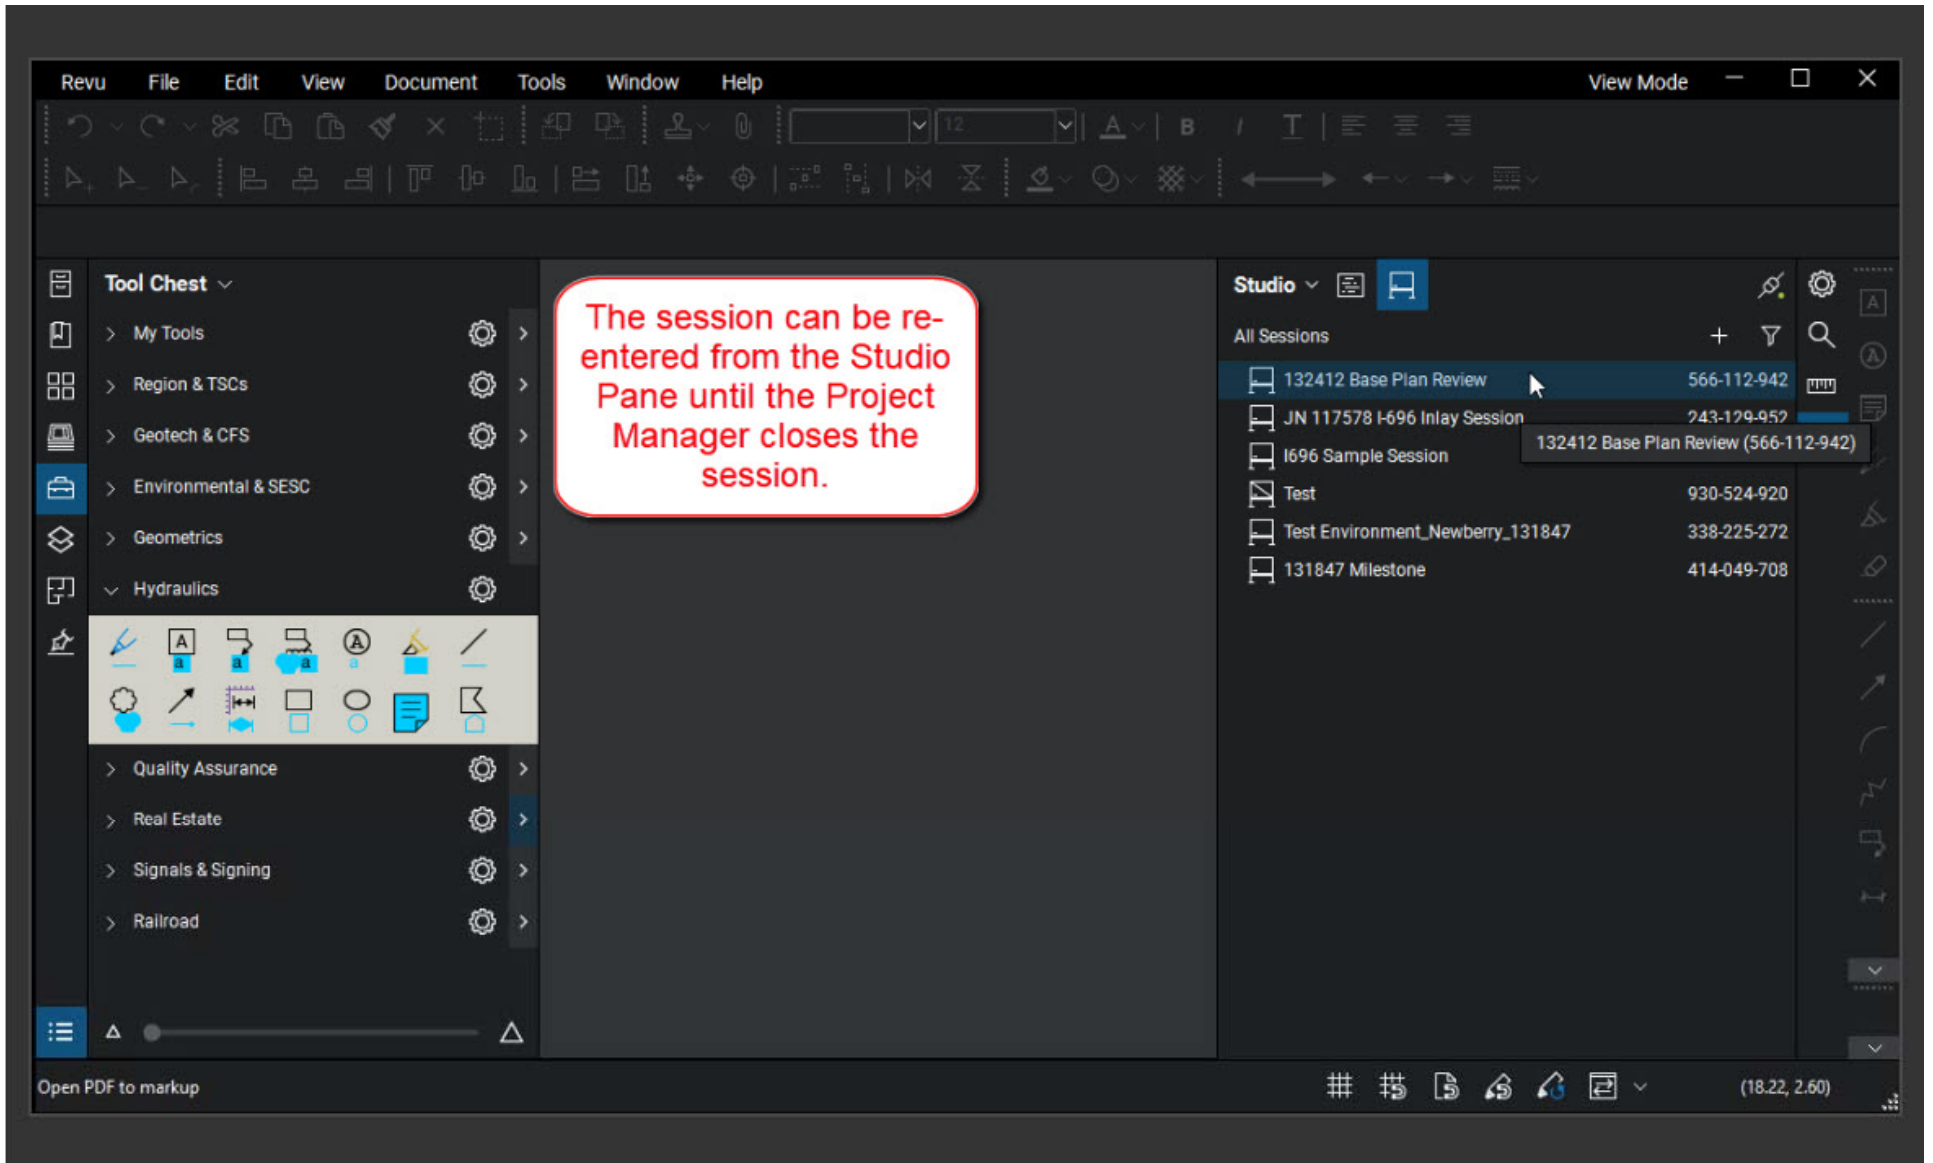



Video Provided By:

**Engineering Support Services
MDOT-EngineeringSupportTraining@michigan.gov**

